






TYPICAL INSTALLATION HORN & STROBE, BELL  
(Tiêu biểu lắp đặt phụ kiện còi, đèn chuông báo)

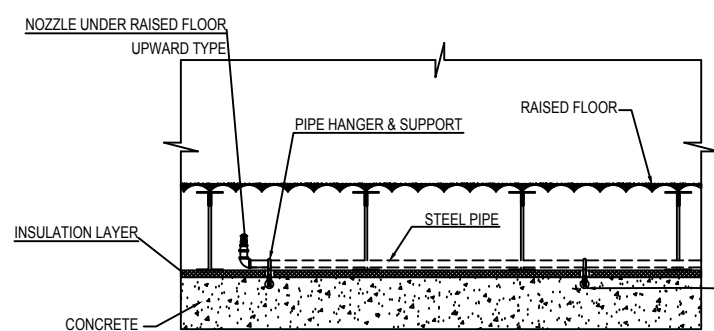


DETAIL 2: PIPING UNDER RAISED FLOOR

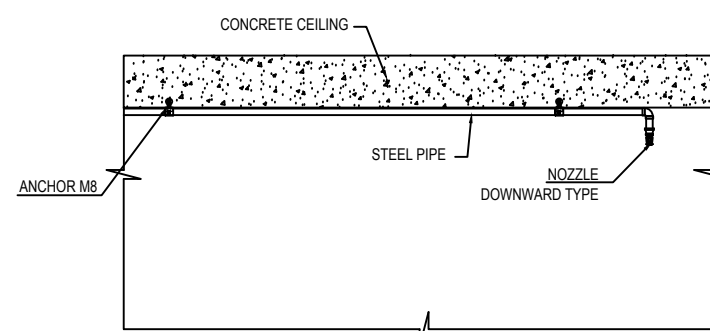


DETAIL 1: PIPING ON CEILING

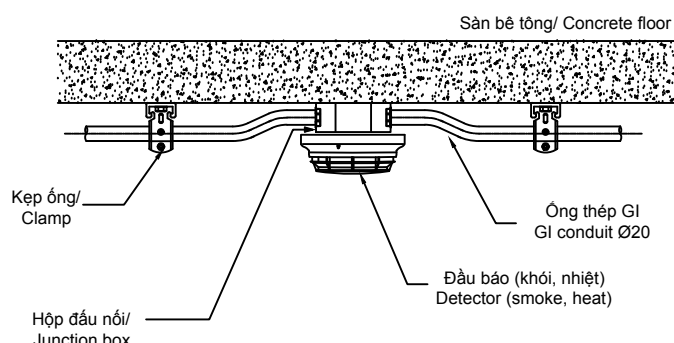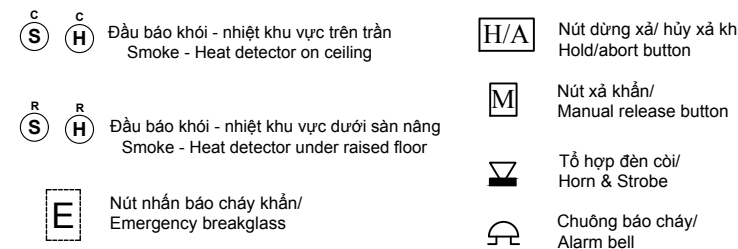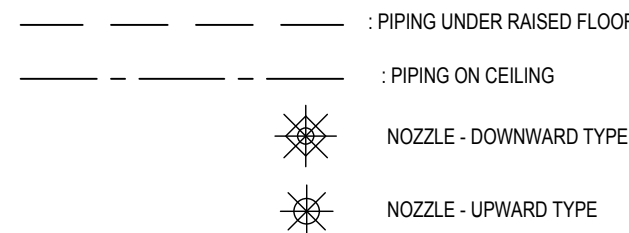

TYPICAL INSTALLATION DETECTOR - ON CEILING  
(Tiêu biểu lắp đặt đầu báo trên trần)

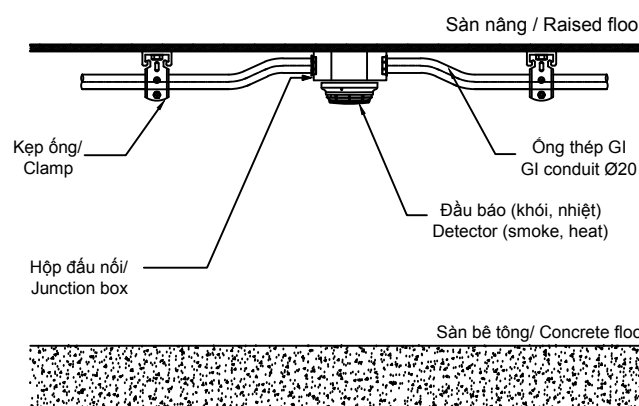

TYPICAL INSTALLATION DETECTOR - UNDER RAISED FLOOR  
(Tiêu biểu lắp đặt đầu báo dưới sàn nâng)

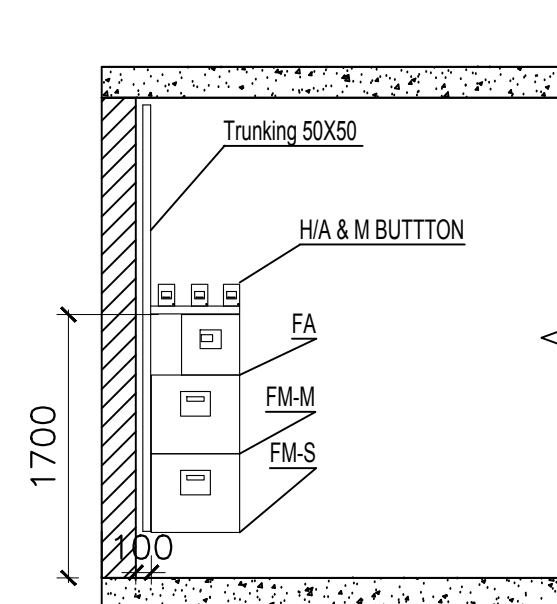

INSTALL PANEL & BUTTON - FRONT VIEW  
(Lắp đặt tủ FM-200 và báo cháy, nút nhấn - mặt đứng)

Tên dự án - Project Name:

Mini Data Center

Floor 10 iTower , 49 Phạm Ngọc Thạch st.,  
Ward 6, Dist.3, HCMC

Chủ đầu tư - Project Owner:

Nguyen Hoang Group

207/3 Nguyễn Văn Thủ st., Dist.1, HCMC

Nhà thầu - Contractor:

DCServices

24 Huỳnh Tinh Cua st., Ward 12  
Tân Bình Dist., HCMC

Thiết kế - Designed by:

Nguyễn Bá Từ

Kiểm - Checked by:

Đinh Ngọc Công Danh

Duyệt - Approved by:

Trần Đại Duy

Chỉnh sửa - Revision:

No.	Date	Description

Tên bản vẽ - Drawing Title:

Hệ thống Báo-Dập cháy  
Mặt bằng tuyến ống dẫn &  
tiêu biểu lắp đặt

Mã bản vẽ - Drawing no.:

ITWR-FIRE-LAYT-1

Chỉnh sửa - Rev. no:

04

Ngày - Date:

20/06/2014

Khô - Format:

A3

Tỉ lệ - Scale:

1:50

Loại bản vẽ - State:


☐ Thiết kế - Conceptual

☐ Triển khai - Implement

☒ Hoàn công - AS built

Chú thích - Notes:

. Any chagings compared to  
last dwg version MUST BE  
marked by cloud with  
following symbol

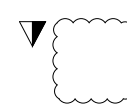

. Unless others stated, all dimensions are mm.  
. Suppliers/ Contractors shall be responsible for  
dimension verification during at site.  
. The internal dwg 'Rev. no' is always at 'xx.yy'  
while externals are 'xx.0'